NOTE.
1. Non-assigned connector should be filled with plug & socket pins.

TECHNICAL DATA:

1. OPERATING VOLTAGE : DC 24 – 48V
2. CURRENT CONSUMPTION : 1A
3. INTERFACE : RS 485
4. COLOR FRONT FRAME : RAL 9005 (BLACK)
5. DISPLAY : SAMSUNG - LMS700KF05(7")
6. NUMBER OF PIXELS : 800x480
7. ACTIVE AREA : 152.4mm[6"] x 91.4mm[3.6"]
8. COLORS : 262k
9. BRIGHTNESS : 450cd/m
10. CONTRAST RATIO : 250 : 1
11. WEIGHT : 1.6kg 2.0kg Aa
12. SURFACE TREATMENT
1) ITEM : NO.1,2,3,4
- COLOR : BLACK
- COLOR CODE : UT-721N TOP N-1.5,G20
- MAKER : PPG

BOLT TYPE DESCRIPTION

11 — Item no.

NO.	TYPE	SIZE	Q'TY
11-1	FLAT HEAD BOLT	M3XL8	16
11-2	ROUND HEAD BOLT	M3XL8	4
	SPRING WASHER	M3X05X1t0.8	
	FLAT WASHER	M3X06.5X1t0.5	
11-3	ROUND HEAD BOLT	M3XL14	8
	SPRING WASHER	M3X05X1t0.8	4
	FLAT WASHER	M3X06.5X1t0.5	
11-4	ROUND HEAD BOLT	M3XL10	6
	SPRING WASHER	M3X05X1t0.8	
	FLAT WASHER	M3X06.5X1t0.5	
	~~FLAT WASHER~~	~~M3X07.5X1t0.5~~	
11-5	NUT	M3	
	SPRING WASHER	M3X05X1t0.8	
	FLAT WASHER	M3X06.5X1t0.5	

X1: CONNECTOR PIN ASSIGMENT
[ITH03FPA22-14PB0G1F6]

NO.	ITEM
A	POWER VCC
B	NC
C	POWER GND
D	NC
E	TX1+(in)
F	TX1−(in)
G	TX1 SH(in)
H	NC
J	NC
K	NC
L	NC
M	CAB ON+
N	CONDUCTOR KEY ON+
P	DI GND
R	NC
S	NC
T	ADD 1
U	ADD 2
V	ADD GND

군번 GROUP NO.					품번 ITEM	품 명 DESCRIPTION	사 양 SPEC	도면번호 DWG NO.	-	품번 및 군번	중량, 길이 폭 x 길이	표면처리 S/TREATMENT
				1	1	FRONT PANEL	AL(A6061)	R1D000315				PAINTING
				1	2	UPPER COVER	A591-CQ, t1	R1D000318				PAINTING
				1	3	REAR COVER	A591-CQ, t1.6	R1D000455				PAINTING
				1	4	FRAME	A366-91,t=1.0	R1D000454				PAINTING
				1	5	TFT-LCD UNIT	LMS700KF05, SAMSUNG					
				1	6	POWER CONVERTER BOARD	CCP-PCB 12V50W, WIS	R1D000316				
				1	7	CCP CONTROL BOARD	CCP-CB, WIS	R1D000313				
				1	8	CONNECTOR	ITH03FPA22-14PB0G1F6 /GLENAIR					
				1	9	CONNECTOR	ITH06F22-14SB0F6 /GLENAIR					
				1	10	NAME PLATE	AL, t=1	R1D000452	-	02		
				1	11	BOLT & NUT LIST	ASS'Y					
				2	12	WIRE MESH	DUST FILTER #25, MYUNG-JIN ELECTRONICS					
				4	13	EMC TAPE	SF050010R-C-NA-A,E-Song					
				1	14	TOUCH SCREEN UNIT	MN070000ACD, 7" Wide, CAZMUS					
				1	15	SPEAKER	HSP-1710-8, HANICS TECHNOLOGY					
				1	16	D/I BOARD	ASS'Y	R1D000314				
				1	17	CR FORM SHEET	CR FORM,EPDM,t=2.0	R1D000453				
				1	18	LCD BRACKET	A366-91,t=1.0	R1D000460				Zn PLATING
				1	19	CAPTIVE SCREW	F5-M4-P2,SOUTHCO					

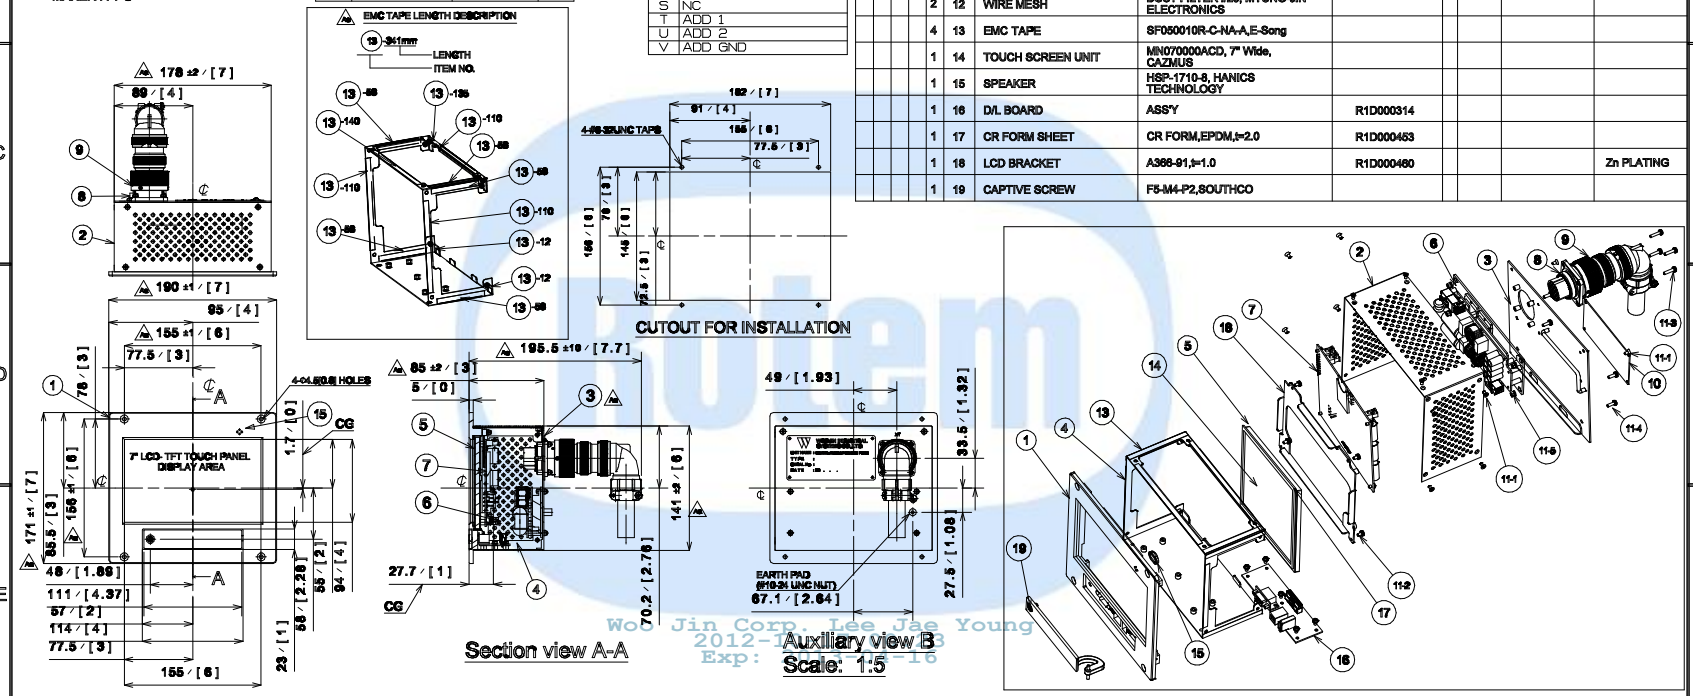

Rotem
Woo Jin Corp. Lee Jae Young
2012-1[illegible]
Exp: [illegible]-16

개정 CHANGE

DGN	H.Y.JEON	APP	B.J.JONE	Aa
2012.03.12				

1) Weight changed.
2) EMC Gasket length changed.
3) PWB-3 P/N changed.
4) PWB-3 connector changed.
5) Tolerance added.

GENERAL TOLERANCE (KWS C-0001)

설계MEMO	DIM. IN mm	작성일 DATE	2011.10.07	승인 APPROVED	B.J.JONE
	척도 SCALE	작성 DRAWN	B.H.KANG		
	1 / 5	설계 DESIGNED	-		
공차 적용기준 : WMS C 40201		검토 CHECKED	J.Y.LEE		

WOOJIN Industrial System Co., Ltd.

DENVER RTD FASTRACKS

COMMUNICATION CONTROL PANEL

R1D1473-25842 Aa

품번 NO.	부품 번호 PART NO.	품 명 DESCRIPTION	재 질 MATERIAL	수량 Q'TY	중량 W.T	비 고 REMARKS

승인 APP	S.H.PARK 2011.03.25	재질 MAT'L	ASSY
검도 CHK	C.H.LEE 2011.03.17	총중량 G.W	4.3 lbs
설계 DGN	Y.S.JEON 2011.03.11	일반공차	MC / WD / CT
제도 DRG		B	
		SIZE	C

명 칭 TITLE: COMMUNICATION CONTROL PANEL

도면 번호 DRG. NO: RES13003CT0 (MS) — Ver. 00 — Rev. -C — RNE1002

SCALE N/S — 매수 SHEET 1 of 1

참고번호 REF. NO.

HYUNDAI Rotem 현대로템주식회사

본-PRJT

정리번호

기 호 MARK	일 자 DATE	변 경 내 역 DETAIL OF REVISION(E.C ZONE)	설변번호 E.C NO.	설계 DGN	검도 CHK	승인 APP
Cx1	2012.03.15	The supplier revised the weight and Dim.	RNE1002-U090	Y.S.JEON	C.Y.LEE	S.H.PARK
Bx1	2012.01.05	The supplier revised painting spec.		Y.S.JEON	C.Y.LEE	S.H.PARK
Ax1	2011.10.25	The supplier revised the drawing for FDR		Y.S.JEON	C.Y.LEE	S.H.PARK

구분	치수	등급 A	등급 B	등급 C
축	~ 40	2	4	
	~ 30	2	3	
	~ 10	1	1.5	
	< 3	0.5	1	
길이	~3150	-	7	
	~1600	4	5	
	~ 800	3	4	
	~ 400	2	3	
	~ 200	1.5	2	
	~ 100	1	1.5	
등급 GRADE		A	B	
주조, 주강품 CASTING (±)				
~ 20M	8	14	24	
~ 15M	7	12	21	
~ 12M	6	10	18	
~ 8M	5	8	14	
~ 4M	4	6	11	
~ 2M	3	4	8	
~ 1M	2	3	6	
~ 315	1	2	4	
~ 120	1	2	3	
~ 30	1	1	1	
등급 GRADE		A	B	C
용접 구조물 WELDING (±)				
~ 20M	-	6.0	8.0	
~ 15M	-	5.0	7.0	
~ 12M	-	4.0	6.0	
~ 8M	-	3.0	5.0	
~ 4M	0.8	2.0	4.0	
~ 2M	0.5	1.2	3.0	
~ 1M	0.3	0.8	2.0	
~ 315	0.2	0.5	1.2	
~ 120	0.15	0.3	0.8	
~ 30	0.1	0.2	0.5	
3~6	0.05	0.1	0.2	
등급 GRADE		A	B	C
기계 가공품 MACHINING (±)				
규정되지 않은 일반공차의 GENERAL TOLERANCE				

Rotem 270430 2012-10-16 10:19

본 도면은 당사 재산으로서 허가없이 무단복사/배포 금지됨. PROPERTY OF ISSUING ENTITY. CANNOT BE DISTRIBUTED OR REPRODUCED WITHOUT AUTHORIZATION.

CATIA