## X15 : PIN ASSIGNMENT
[FRITS4102R14S-07PB0G1F6]

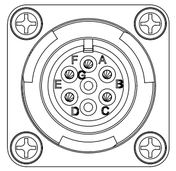


| PIN NO. | PIN | REMARK |
|---|---|---|
| A | TD | MAKER SUPPLY |
| B | RD | |
| C | SHIELD | |
| D | SPARE | |
| E | DC +5V OUT | |
| F | DC GND OUT | |
| G | SPARE | |

## X16 : PIN ASSIGNMENT
[801-009-07M9-210PA]

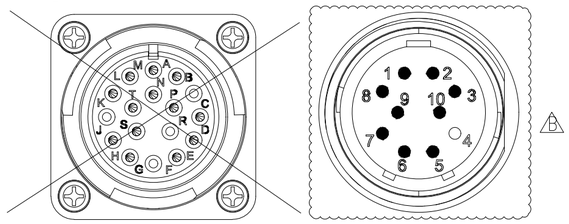


| PIN NO. | CBL NO. | CBL SIZE | REMARK |
|---|---|---|---|
| ~~A~~ 1 | 8206/1 | ~~16, 2C~~ 20, 2C | TX1+ |
| ~~B~~ 2 | 8206/2 | ~~16, 2C~~ 20, 2C | TX1- |
| ~~C~~ 3 | 8206/S | ~~16, 2C~~ 20, 2C | TX1 SH |
| ~~D~~ 4 | - | - | ~~SPARE~~ - |
| ~~E~~ 5 | 8205/1 | 20, 2C | RS485 TL1+ |
| ~~F~~ 6 | 8205/2 | 20, 2C | RS485 TL1- |
| ~~G~~ 7 | 8205/S | 20, 2C | RS485 TL1 SH |
| ~~H~~ 8 | 8215/1 | 20, 2C | RS485 TL2+ |
| ~~J~~ 9 | 8215/2 | 20, 2C | RS485 TL2- |
| ~~K~~ 10 | 8215/S | 20, 2C | RS485 TL2 SH |
| L | | | |
| M | | | |
| N | | | |
| P | | | |
| R | | | |
| S | | | |
| T | | | |

## X5 : PIN ASSIGNMENT
[MSC59RR-L111]

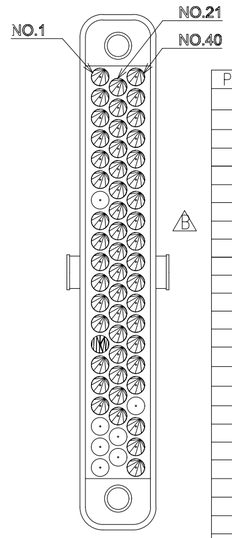


| PIN NO. | CBL NO. | CBL SIZE | REMARK | PIN NO. | CBL NO. | CBL SIZE | REMARK |
|---|---|---|---|---|---|---|---|
| 1 | 84L09 | 16 | PEI LIVE-ADD GND | 31 | - | - | |
| 2 | 84L01 | 16 | PEI1 LIVE-ADD | 32 | - | - | |
| 3 | 84L02 | 16 | PEI2 LIVE-ADD | 33 | - | - | |
| 4 | 84L03 | 16 | PEI3 LIVE-ADD | 34 | - | - | |
| 5 | 84L04 | 16 | PEI4 LIVE-ADD | 35 | - | - | |
| 6 | ~~84L05~~ 84L05(MA),84L06(MB) | 16 | ~~PEI5 LIVE-ADD~~ CAB KEY ON MA | 36 | - | - | |
| 7 | ~~84L06~~ 84L06(MA),84L05(MB) | 16 | ~~PEI6 LIVE-ADD~~ CAB KEY ON MB | 37 | - | - | |
| 8 | ~~84L07~~ 84L07(MA),84L08(MB) | 16 | ~~PEI7 LIVE-ADD~~ UNCOUPLE MA | 38 | - | - | |
| 9 △B | ~~84L08~~ 84L08(MA),84L07(MB) | 16 | ~~PEI8 LIVE-ADD~~ UNCOUPLE MB | 39 | - | - | |
| 10 | - | - | | 40 | - | - | |
| 11 | 84L30 | 16 | DPO LIVE-ADD1 | 41 | - | - | |
| 12 | 84L31 | 16 | DPO LIVE-ADD2 | 42 | - | - | |
| 13 | 84L32 | 16 | DPO LIVE-ADD GND | 43 | - | - | |
| 14 | - | - | | 44 | - | - | |
| 15 | 84L38 | 16 | DPH LIVE-ADD1 | 45 | 8441/S | 16, 2C | AUDIO1 SH |
| 16 | 84L39 | 16 | DPH LIVE-ADD2 | 46 | 8441/1 | 16, 2C | AUDIO1+ |
| 17 | 84L40 | 16 | DPH LIVE-ADD GND | 47 | 8441/2 | 16, 2C | AUDIO1- |
| 18 | - | - | - | 48 | 8445/S | 16, 2C | AUDIO2 SH |
| 19 | - | - | - | 49 | 8445/1 | 16, 2C | AUDIO2+ |
| 20 | - | - | - | 50 | 8445/2 | 16, 2C | AUDIO2- |
| 21 | - | - | - | 51 | 8451/S | 16, 2C | AUDIO3 SH |
| 22 | - | - | - | 52 | 8451/1 | 16, 2C | AUDIO3+ |
| 23 | - | - | - | 53 | 8451/2 | 16, 2C | AUDIO3- |
| 24 | - | - | - | 54 | 8453/S | 16, 2C | AUDIO4 SH |
| 25 | - | - | - | 55 | 8453/1 | 16, 2C | AUDIO4+ |
| 26 | - | - | - | 56 | 8453/2 | 16, 2C | AUDIO4- |
| 27 | - | - | - | 57 | 8440/S | 16, 2C | AUDIO5 SH |
| 28 | - | - | - | 58 | 8440/1 | 16, 2C | AUDIO5+ |
| 29 | - | - | - | 59 | 8440/2 | 16, 2C | AUDIO5- |
| 30 | - | - | - | | | | |

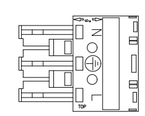


FAN

| Pin No. | CBL NO. | CABLE SIZE | Remarks |
|---|---|---|---|
| L | 38B93-5 | 16 | POWER |
| N | 38G93-5 | 16 | POWER-GND |

NOTE :

1. FABRICATE HARNESS ASSEMBLY IN ACCORDANCE WITH REDE114797
   - SECTION. 16. MATERIAL AND WORKMANSHIP OF RTD CONCESSION AGREEMENT ATTACHMENT 7 . PART C
2. CONNECTION FOR EARTHING CABLE SHOULD BE FOLLOWED WITH REW000121CT0 (CHASSIS EARTHING DRAWING).
3. IF IT NEEDS A WIRING CONNECTION AT STUD TYPE TERMINAL SERIES, RING TERMINAL AND TERMINAL LUG SHOULD BE USED.
   RING TERMINAL AND TERMINAL LUG SHALL BE USED WITH BEING APPROVED (REFER TO DWG. REW000123CT0).
4. CP PART NUMBER IS INCORPORATED WITH Dwg No. CP710007
5. CRIMPING APPLICATION TOOL IS FOLLOWED WITH T&B VENDOR'S RECOMMENDATION.
6. DETAIL INFORMATION OF MAKER CABLES SUPPLIED BY EACH SUB-SYSTEM IS PROVIDED AT DWG NO.REW000122CT0
7. UNLESS OTHERWISE MENTIONED AT PIN ASSIGNMENT DWG, USING BUTT SPLICE IS NOT ALLOWED
8. IF IT NEEDS A WIRING CONNECTION AT WAGO SERIES CONNECTOR OR CAGE CLAMP TYPE TERMINAL BLOCK, FERRULES SHOULD BE USED.
9. DESIGNATION SLEEVE AT EACH END OF WIRE SHOULD BE SHRINKED
10. EMPTY HOLE OF CONNECTOR MUST BE PLUGGED WITH ACTUAL PIN FOR PRIMARY FUNCTION.
11. ALL OF THE CONNECTOR ACCESSORY MUST BE APPLIED WITH GROMMET, GASKET, BACKSHELL, CLAMP AND RUBBER TUBE.

NOTE

| | | | |
|---|---|---|---|
| 두께 THICKNESS | ~ 40 | 2 | 4 |
| | ~ 30 | 2 | 3 |
| | ~ 10 | 1 | 1.5 |
| | < 3 | 0.5 | 1 |
| 길이 LENGTH | ~3150 | - | 7 |
| | ~1600 | 4 | 5 |
| | ~ 800 | 3 | 4 |
| | ~ 400 | 2 | 3 |
| | ~ 200 | 1.5 | 2 |
| | ~ 100 | 1 | 1.5 |
| 등급 GRADE | | A | B |

| 주철 주강품 CASTING | | | (±) |
|---|---|---|---|
| ~ 20M | 8 | 14 | 24 |
| ~ 15M | 7 | 12 | 21 |
| ~ 12M | 6 | 10 | 18 |
| ~ 8M | 5 | 8 | 14 |
| ~ 4M | 4 | 6 | 11 |
| ~ 2M | 3 | 4 | 8 |
| ~ 1M | 2 | 3 | 6 |
| ~ 315 | 1 | 2 | 4 |
| ~ 120 | 1 | 2 | 3 |
| ~ 30 | 1 | 1 | 1 |
| 등급 GRADE | A | B | C |

| 용접 구조물 WELDING | | | (±) |
|---|---|---|---|
| ~ 20M | - | 6.0 | 8.0 |
| ~ 15M | - | 5.0 | 7.0 |
| ~ 12M | - | 4.0 | 6.0 |
| ~ 8M | - | 3.0 | 5.0 |
| ~ 4M | 0.8 | 2.0 | 4.0 |
| ~ 2M | 0.5 | 1.2 | 3.0 |
| ~ 1M | 0.3 | 0.8 | 2.0 |
| ~ 315 | 0.2 | 0.5 | 1.2 |
| ~ 120 | 0.15 | 0.3 | 0.8 |
| ~ 30 | 0.1 | 0.2 | 0.5 |
| 3~6 | 0.05 | 0.1 | 0.2 |
| 등급 GRADE | A | B | C |
| 기계 가공품 MACHINING | | | (±) |
| 규정치않은 일반공차표 GENERAL TOLERANCE | | | |

| MARK | DATE | DETAIL OF REVISION(E.C ZONE) | E.C NO. | DGN | CHK | APP |
|---|---|---|---|---|---|---|
| △D x1 | 2018.01.11 | ADDED FAN | RNE1002-U472 | S.H.LEE | H.S.PARK | D.I.KIM |
| △C x2 | 2013.02.15 | CHANGED WIRING CABLE SIZE OF 'X16' | RNE1002-U266 | S.H.LEE | H.S.PARK | D.I.KIM |
| △B x3 | 2012.10.05 | CHANGED CN X16 MODEL NO. AND PIN NO AND X5 PIN 5~8 WIRE NUMBERS | RNE1002-U180 | S.H.LEE | H.S.PARK | D.I.KIM |
| △A x1 | 2012.08.31 | CHANGED CN X16 PIN NO | RNE1002-U157 | J.H.KIM | H.S.PARK | D.I.KIM |

기호 MARK | 일자 DATE | 변경내역 DETAIL OF REVISION(E.C ZONE) | 설변번호 E.C NO. | 설계 DGN | 검도 CHK | 승인 APP

| 품번 NO. | 부품 번호 PART NO. | 품명 DESCRIPTION | 재질 MATERIAL | 수량 Q'TY | 중량 W.T | 비고 REMARKS |
|---|---|---|---|---|---|---|
| 승인 APP | D.I.KIM 2012.05.20 | 재질 MAT'L NA | | | | |
| 검도 CHK | H.S.PARK 2012.05.20 | 총중량 G.W NA | | | | |
| 설계 DGN | J.H.KIM 2012.05.20 | 일반공차 MC WD CT | | | | |
| 제도 DRG | | SIZE C | | | | |

참고번호 REF. NO.

명칭 TITLE: PIN ARRANGEMENT,COMM.RACK(2/2)

도면번호 DRG. NO: REW00084CT0 (MS) Ver. 00 Rev. -D

SCALE | 매수 SHEET 2 of 2

HYUNDAI Rotem 현대로템주식회사

RNE1002 | 년-PRJT | 정리번호

본 도면은 당사 재산으로서 허가없이 무단복사/배포 금지함. PROPERTY OF ISSUING ENTITY. CANNOT BE DISTRIBUTED OR REPRODUCED WITHOUT AUTHORIZATION.

AutoCAD