군번 GROUP NO.	품번 ITEM	품 명 DESCRIPTION	사 양 SPEC	도면번호 DWG NO.	-	품번 원단	중량. 길이 폭 x 길이	표면처리 S/TREATMENT
1	1	GOOSENECK MIC	DGN99E/AKG					
1	2	XLR CONNECTOR	3-PIN MALE XLR/MTM					
1	3	WIRE	100G1121-0.5-0/9/RAYCHEM					
1	4	NAME LABEL	COTTON PAPER	R1D000452	-	17		
1	5	CONNECTOR	770-213/WAGO					
1	6	CONNECTOR	770-203/WAGO					
1	7	LOCKING LEVER	770-101/WAGO					
1	8	HARNESS	100G0111-2.5-0/RAYCHEM					
3	9	BOLT	~~#6-32~~ ~~#8-40~~,1/2INCH					

Note:Item #1 and #2 should be fastened within 0.8 kgf-m.(5.8 lbf-ft)

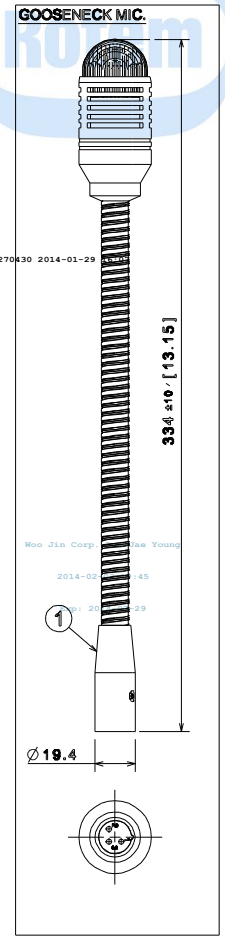

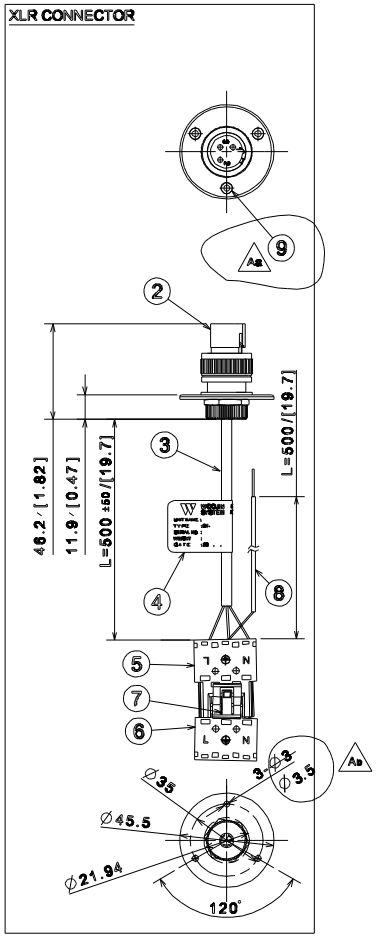

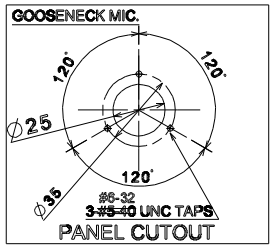

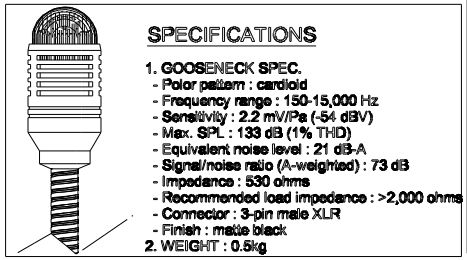

SPECIFICATIONS

1. GOOSENECK SPEC.
   - Polar pattern : cardioid
   - Frequency range : 150-15,000 Hz
   - Sensitivity : 2.2 mV/Pa (-54 dBV)
   - Max. SPL : 133 dB (1% THD)
   - Equivalent noise level : 21 dB-A
   - Signal/noise ratio (A-weighted) : 73 dB
   - Impedance : 530 ohms
   - Recommended load impedance : >2,000 ohms
   - Connector : 3-pin male XLR
   - Finish : matte black
2. WEIGHT : 0.5kg

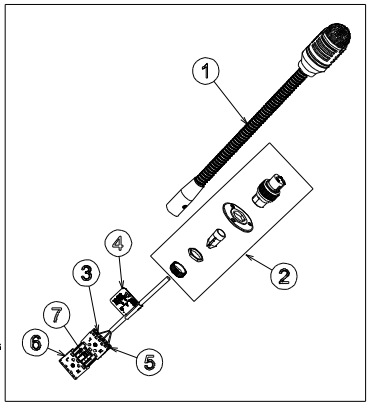

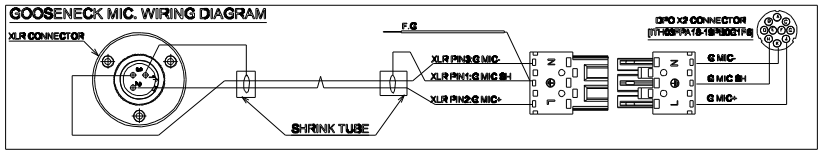

개정 CHANGE			
Redrawing. 2012.06.12	DGN	HY.SHIN	B.J.JONE
Rlvs. 9 added. 2012.12.05	DGN	HY.SHIN	B.J.JONE
Rlvs. 9 note changed. 2014.01.16	DGN	HY.SHIN	B.J.JONE

GENERAL TOLERANCE (WMS C-0201)

설계MEMO

DIM. IN mm	작성일 DATE	2011.10.07	승인 APPROVED
척도 SCALE	작성 DRAWN	B.H.KANG	B.J.JONE
1 / 2	설계 DESIGNED	-	
공차 적용기준 : WMS C 40201	검도 CHECKED	J.Y.LEE	

WOOJIN Industrial Systems Co.,Ltd.

DENVER RTD FASTRACKS

DRIVER MICROPHONE ASSEMBLY (DMA:GOOSENECK MIC)

R1D1473-25863 Aa

기호 MARK	일자 DATE	변경내역 DETAIL OF REVISION(E.C ZONE)	설변번호 E.C NO.	설계 DGN	검도 CHK	승인 APP
Hx1	2014.01.14	Changed the item No. 9 (#5 to #6).	RNE1002-U394	Y.S.JEON	C.Y.LEE	S.H.PARK
Gx1	2013.07.17	Added the limited fastening torque.	RNE1002-U345	Y.S.JEON	C.Y.LEE	S.H.PARK
Fx1	2012.12.05	The supplier added the item #9.	RNE1002-U144	Y.S.JEON	C.Y.LEE	S.H.PARK
Ex1	2012.03.15	The supplier revised the shape of Mic.		Y.S.JEON	C.Y.LEE	S.H.PARK
Dx1	2012.01.05	The supplier inserted connector spec.		Y.S.JEON	C.Y.LEE	S.H.PARK
Cx1	2011.12.29	The Connector is detailed		Y.S.JEON	C.Y.LEE	S.H.PARK
Bx1	2011.10.25	The supplier revised the drawing for FDR		Y.S.JEON	C.Y.LEE	S.H.PARK
Ax1	2011.08.10	The shape of MIC was changed by CUSTOMER		Y.S.JEON	C.Y.LEE	S.H.PARK

품번 NO.	부품 번호 PART NO.	품 명 DESCRIPTION	재질 MATERIAL	수량 Q'TY	유효 V.T	비고 REMARKS
승인 APP	S.H.PARK 2011.03.25	재질 MAT'L ASSY				
검도 CHK	C.Y.LEE 2011.03.17	총중량 G.W 0.8 lbs				
설계 DGN	Y.S.JEON 2011.03.11	일반공차				
제도 DRG						

TITLE: DRIVER MICROPHONE ASSY

DRG. NO: RES14002CT0 (MS) Ver. 00 Rev. -H RNE1002

SCALE N/S | SHEET 1 of 1 | SIZE D

HYUNDAI Rotem 현대로템주식회사

본 도면은 동사 재산으로써 외부에의 무단복사/배포 금지함 : PROPERTY OF ISSUING ENTITY, CANNOT BE DISTRIBUTED OR REPRODUCED WITHOUT AUTHORIZATION.